


DANSVILLE SCHOOLS ADDITION / RENOVATIONS

DANSVILLE SCHOOLS


1264 ADAMS ST.
DANSVILLE, MI 48819

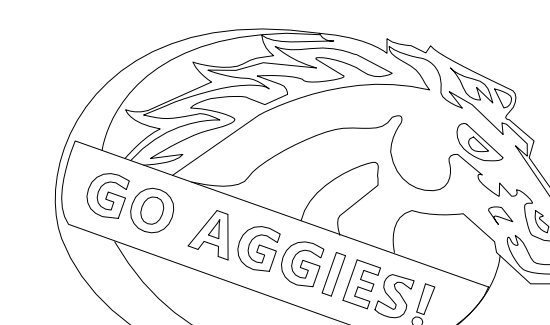

Dansville
School District

ISSUANCES DATE
CONSTRUCTION SET 07/31/2017

Revisions		
No.	Date	Description
PBA2	06/19/2017	POST BID ADDENDUM 2

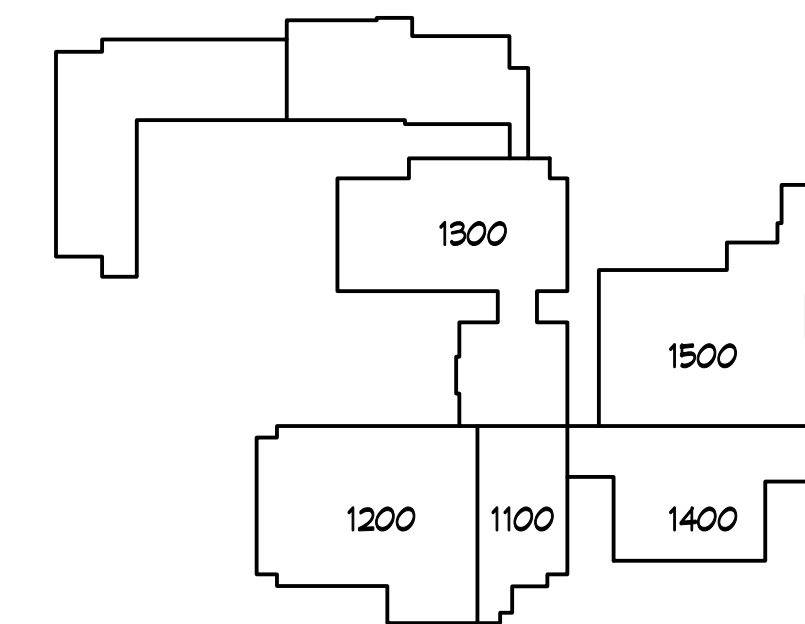

JOB NO. 2125.04




SHEET TITLE
LOWER COMPOSITE
PLAN

SHEET NO.

A0.1X

MS SWITCH LOCATIONS ARE IN RED
WITH BOX/ARROW

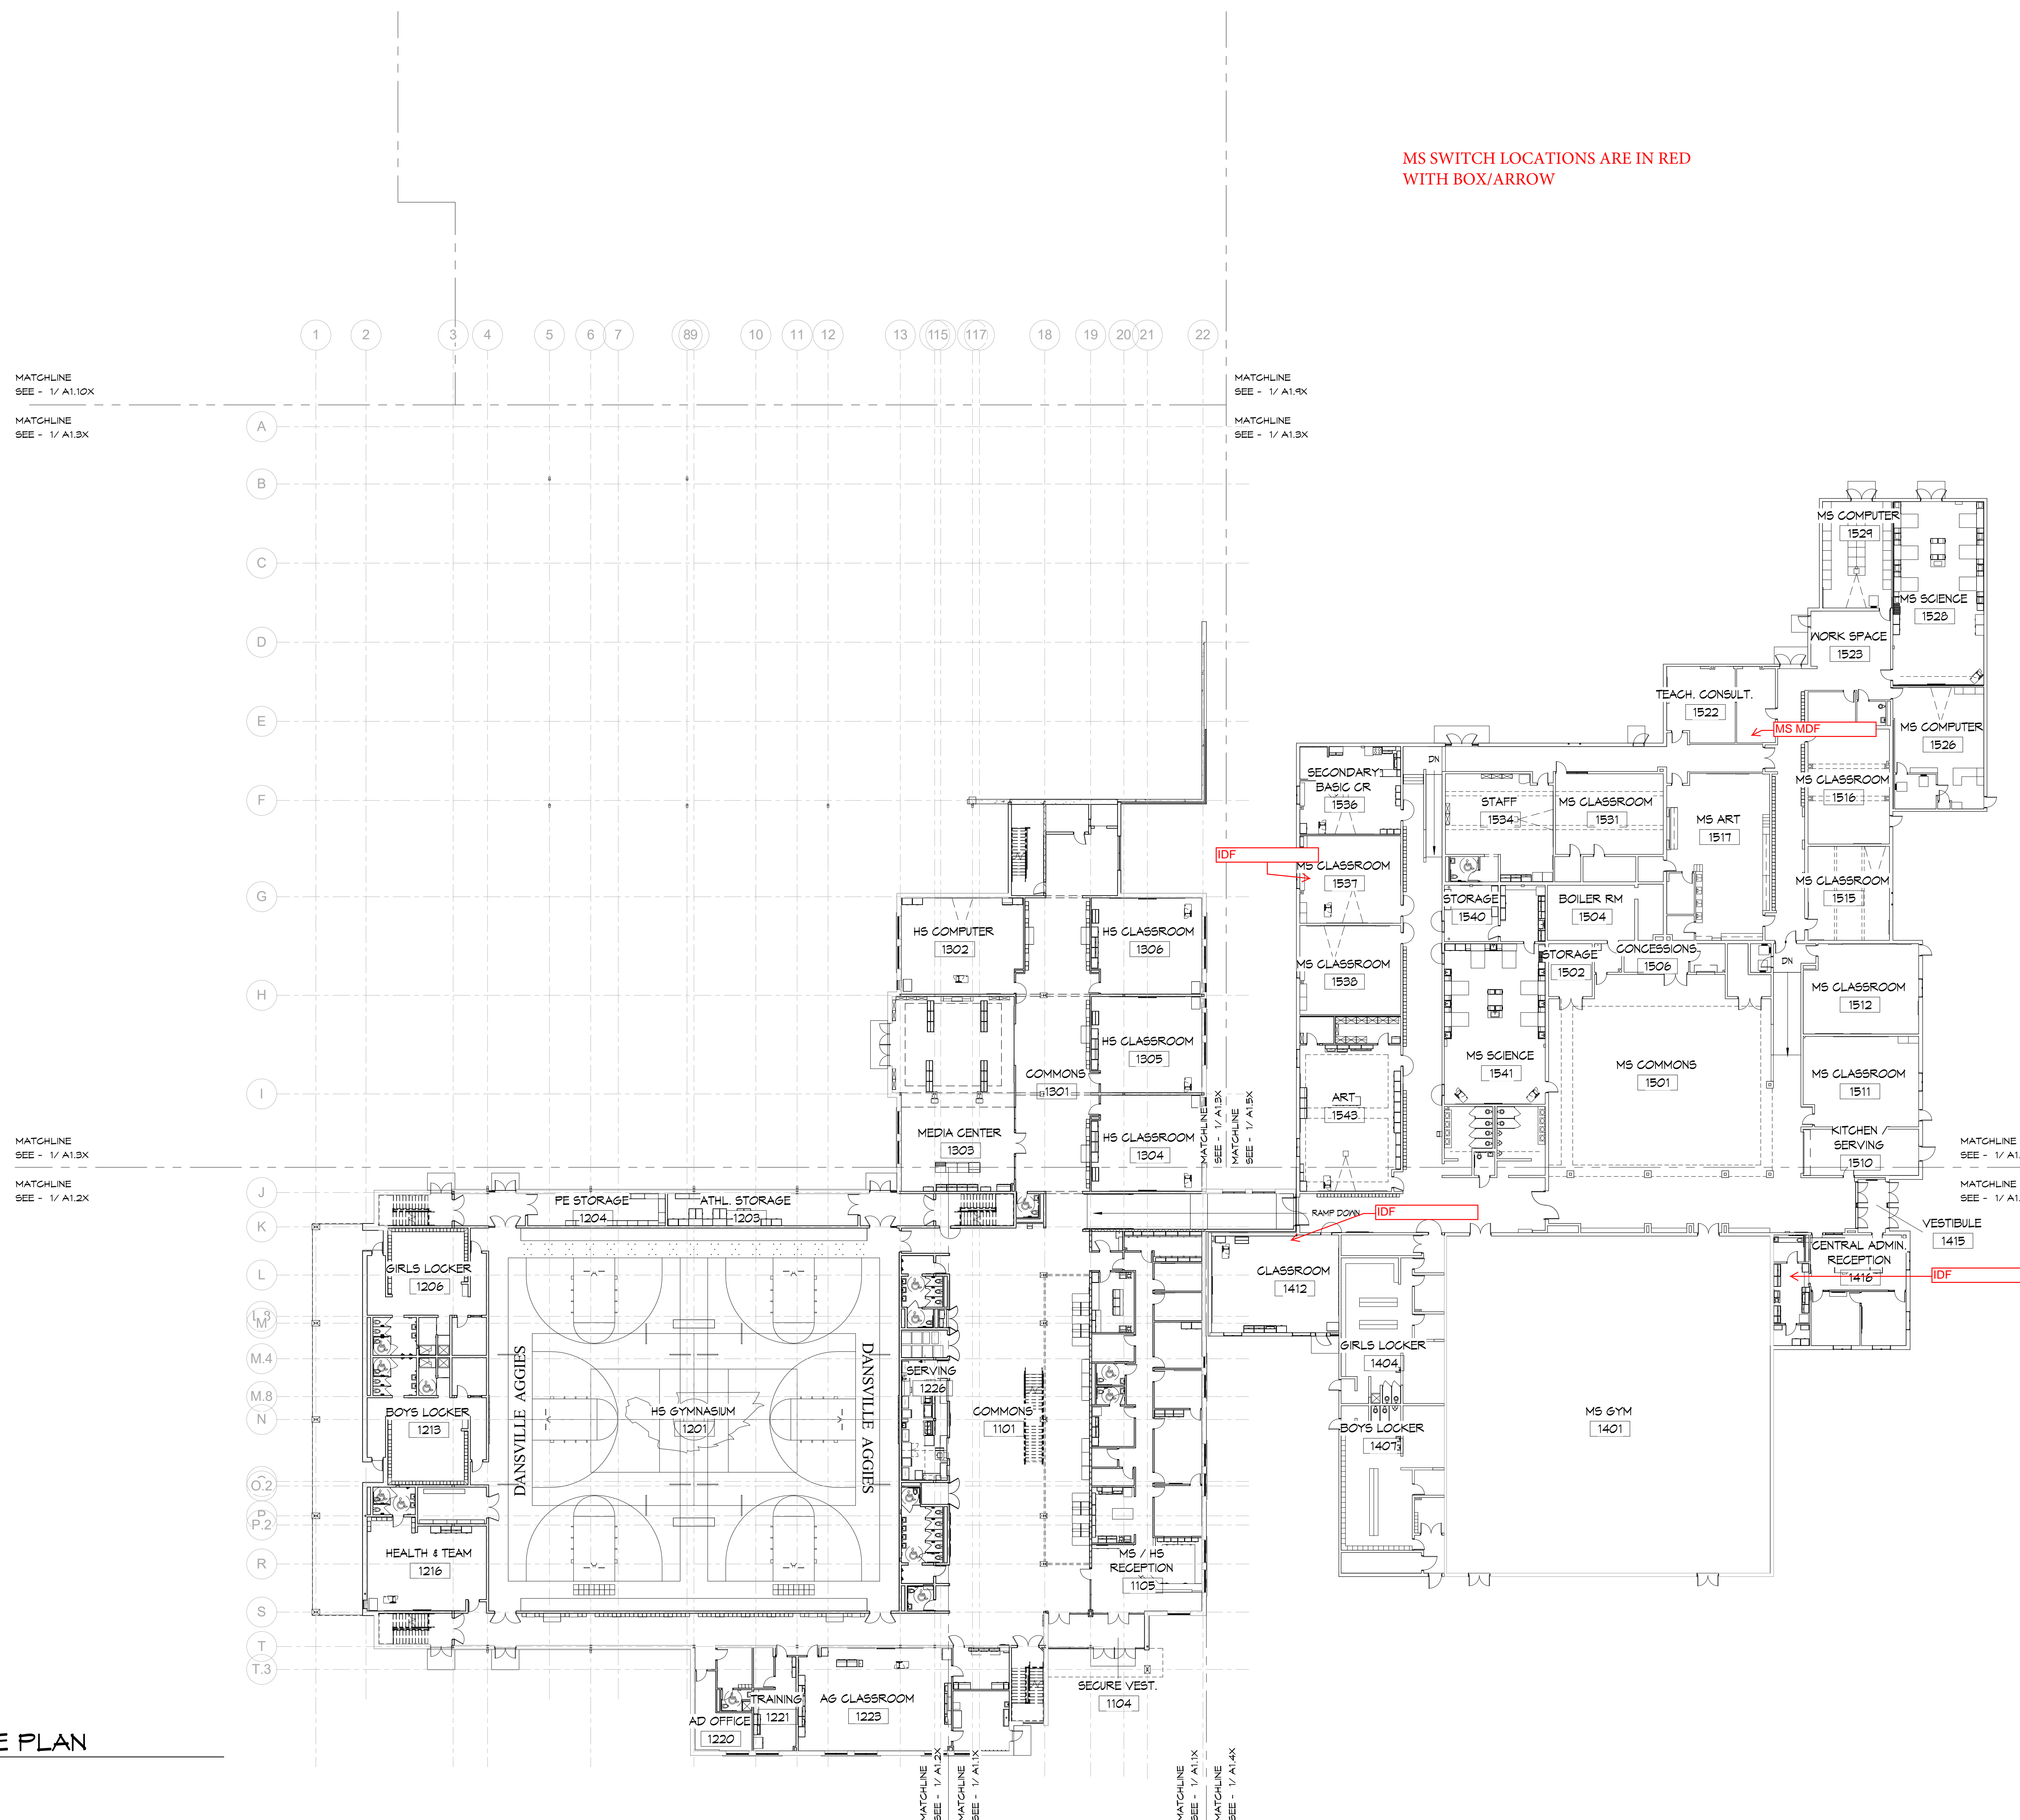

1 LOWER COMPOSITE PLAN
1" = 20'-0"